

1/2

SITE PLAN

CITY OF M-O-L. LAKE COUNTY, OHIO

for: R.T.R.

CLIENT OWNER ADDRESS STREET CITY ZIP

FOURTH SALIDA SUBDIVISION C-34 NAME TRACT STREET LOT 19A-89H-48 PT. 122, 123 VOL-PG SALIDA LOT 19A-89H-48 SUBLOT NO. STREET VOL-PG PERM. PARCEL NO.

LEGEND

SANITARY MANHOLE --- 100.0 DIST. ELEV. --- 100.0 PROP. ELEV. 100.0 AS BUILT ELEVATION INDICATES DIRECTION OF SURFACE DRAINAGE

REMARKS

ALL BOUNDARY DATA SHOWN WAS OBTAINED FROM (DEEDS, RECORDED SUBDIVISION PLAT OR OTHER PUBLIC RECORDS) LOCATIONS AS SHOWN OF ADJACENT WELLS AND SEPTIC TANKS OBTAINED FROM LAKE COUNTY HEALTH DEPARTMENT

DESIGN CERTIFICATION

THIS PLAT WAS PREPARED BY ME, AND IS CORRECT TO THE BEST OF MY KNOWLEDGE AND BELIEF.

NAME SURVEYOR REGISTRATION NO.

CHECK LIST

NO. OF BEDROOMS DIMENSIONS BEARINGS TIE TO NEAREST STREET SUBLOT NO. PARCEL NO. SURROUNDING OWNERS BLDG. DIMENSIONS FIN GR. GRADES APRON TYPE WIDTH THICKNESS SIDEWALK TYPE WIDTH THICKNESS CULVERT TYPE DIA. LENGTH ROCK OUTCROPPINGS WATER MAIN SIZE, LOCATION SAN. SEWER SIZE & GR. LOC. SAN. MH. CAST. ELEV. INV. ELEV. SAN. CONN. SIZE, LOC. DEPTH STORM SEWER SIZE & GR. LOC. STORM MH. CAST. ELEV. INV. ELEV. PAVT TYPE GRADE CURBS GAS LINE LOC. SIZE PRESSURE SEPTIC TANK LOCATION & DUPLICATION AREA WELL LOCATION ISOLATION RADIUS FROM WELL

REVISIONS

NO.	DATE	BY
1		
2		
3		
4		
5		

PLAN PREPARED BY: BABCOCK JONES & ASSOCIATES, INC. PAINESVILLE, OHIO DRAWN BY B.P. SCALE 1"=20' PHONE NO. 440-357-1811 CHK'D. H.J. DATE 1/18/08 DRAWING NO. 07-194 CREW CHIEF W.B. APP'D H.J.

"AS BUILT" CERTIFICATION

I, HEREBY CERTIFY THAT THE CIRCLED GRADES ARE EXISTING FINISH GRADES CHECKED IN THE FIELD ON 1-29-08 AND ARE CORRECT TO THE BEST OF MY KNOWLEDGE AND BELIEF.

REGISTERED SURVEYOR


REG. NO.

TBM - T.S.F.H. ELEV - 598.63

APPROVED CT CONSULTANTS INC.

CITY ENGINEER 1-29-08 DATE

GRAPHIC SCALE

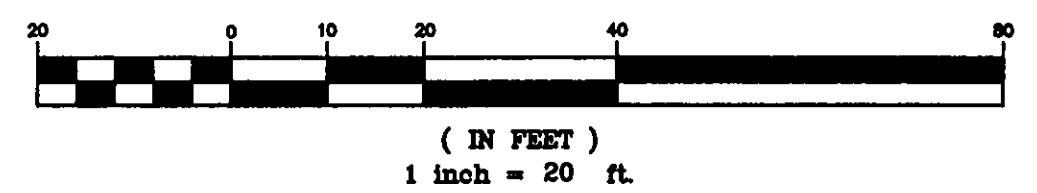

EXISTING UTILITIES NOTE: THE SIZE AND LOCATION, BOTH HORIZONTAL AND VERTICAL OF THE UNDERGROUND UTILITIES SHOWN HEREON, HAVE BEEN OBTAINED BY A SEARCH OF AVAILABLE RECORDS. VERIFICATION BY FIELD OBSERVATION HAS BEEN CONDUCTED WHERE PRACTICAL. HOWEVER, BABCOCK, JONES AND ASSOCIATES INC. DOES NOT GUARANTEE THE COMPLETENESS NOR ACCURACY THEREOF.



By County Drainage Engineer Date 2-4-08

08011